


REDLINED SHEET

FIG. 1
PRIOR ART

REPLACEMENT SHEET

FIG. 1
PRIOR ART

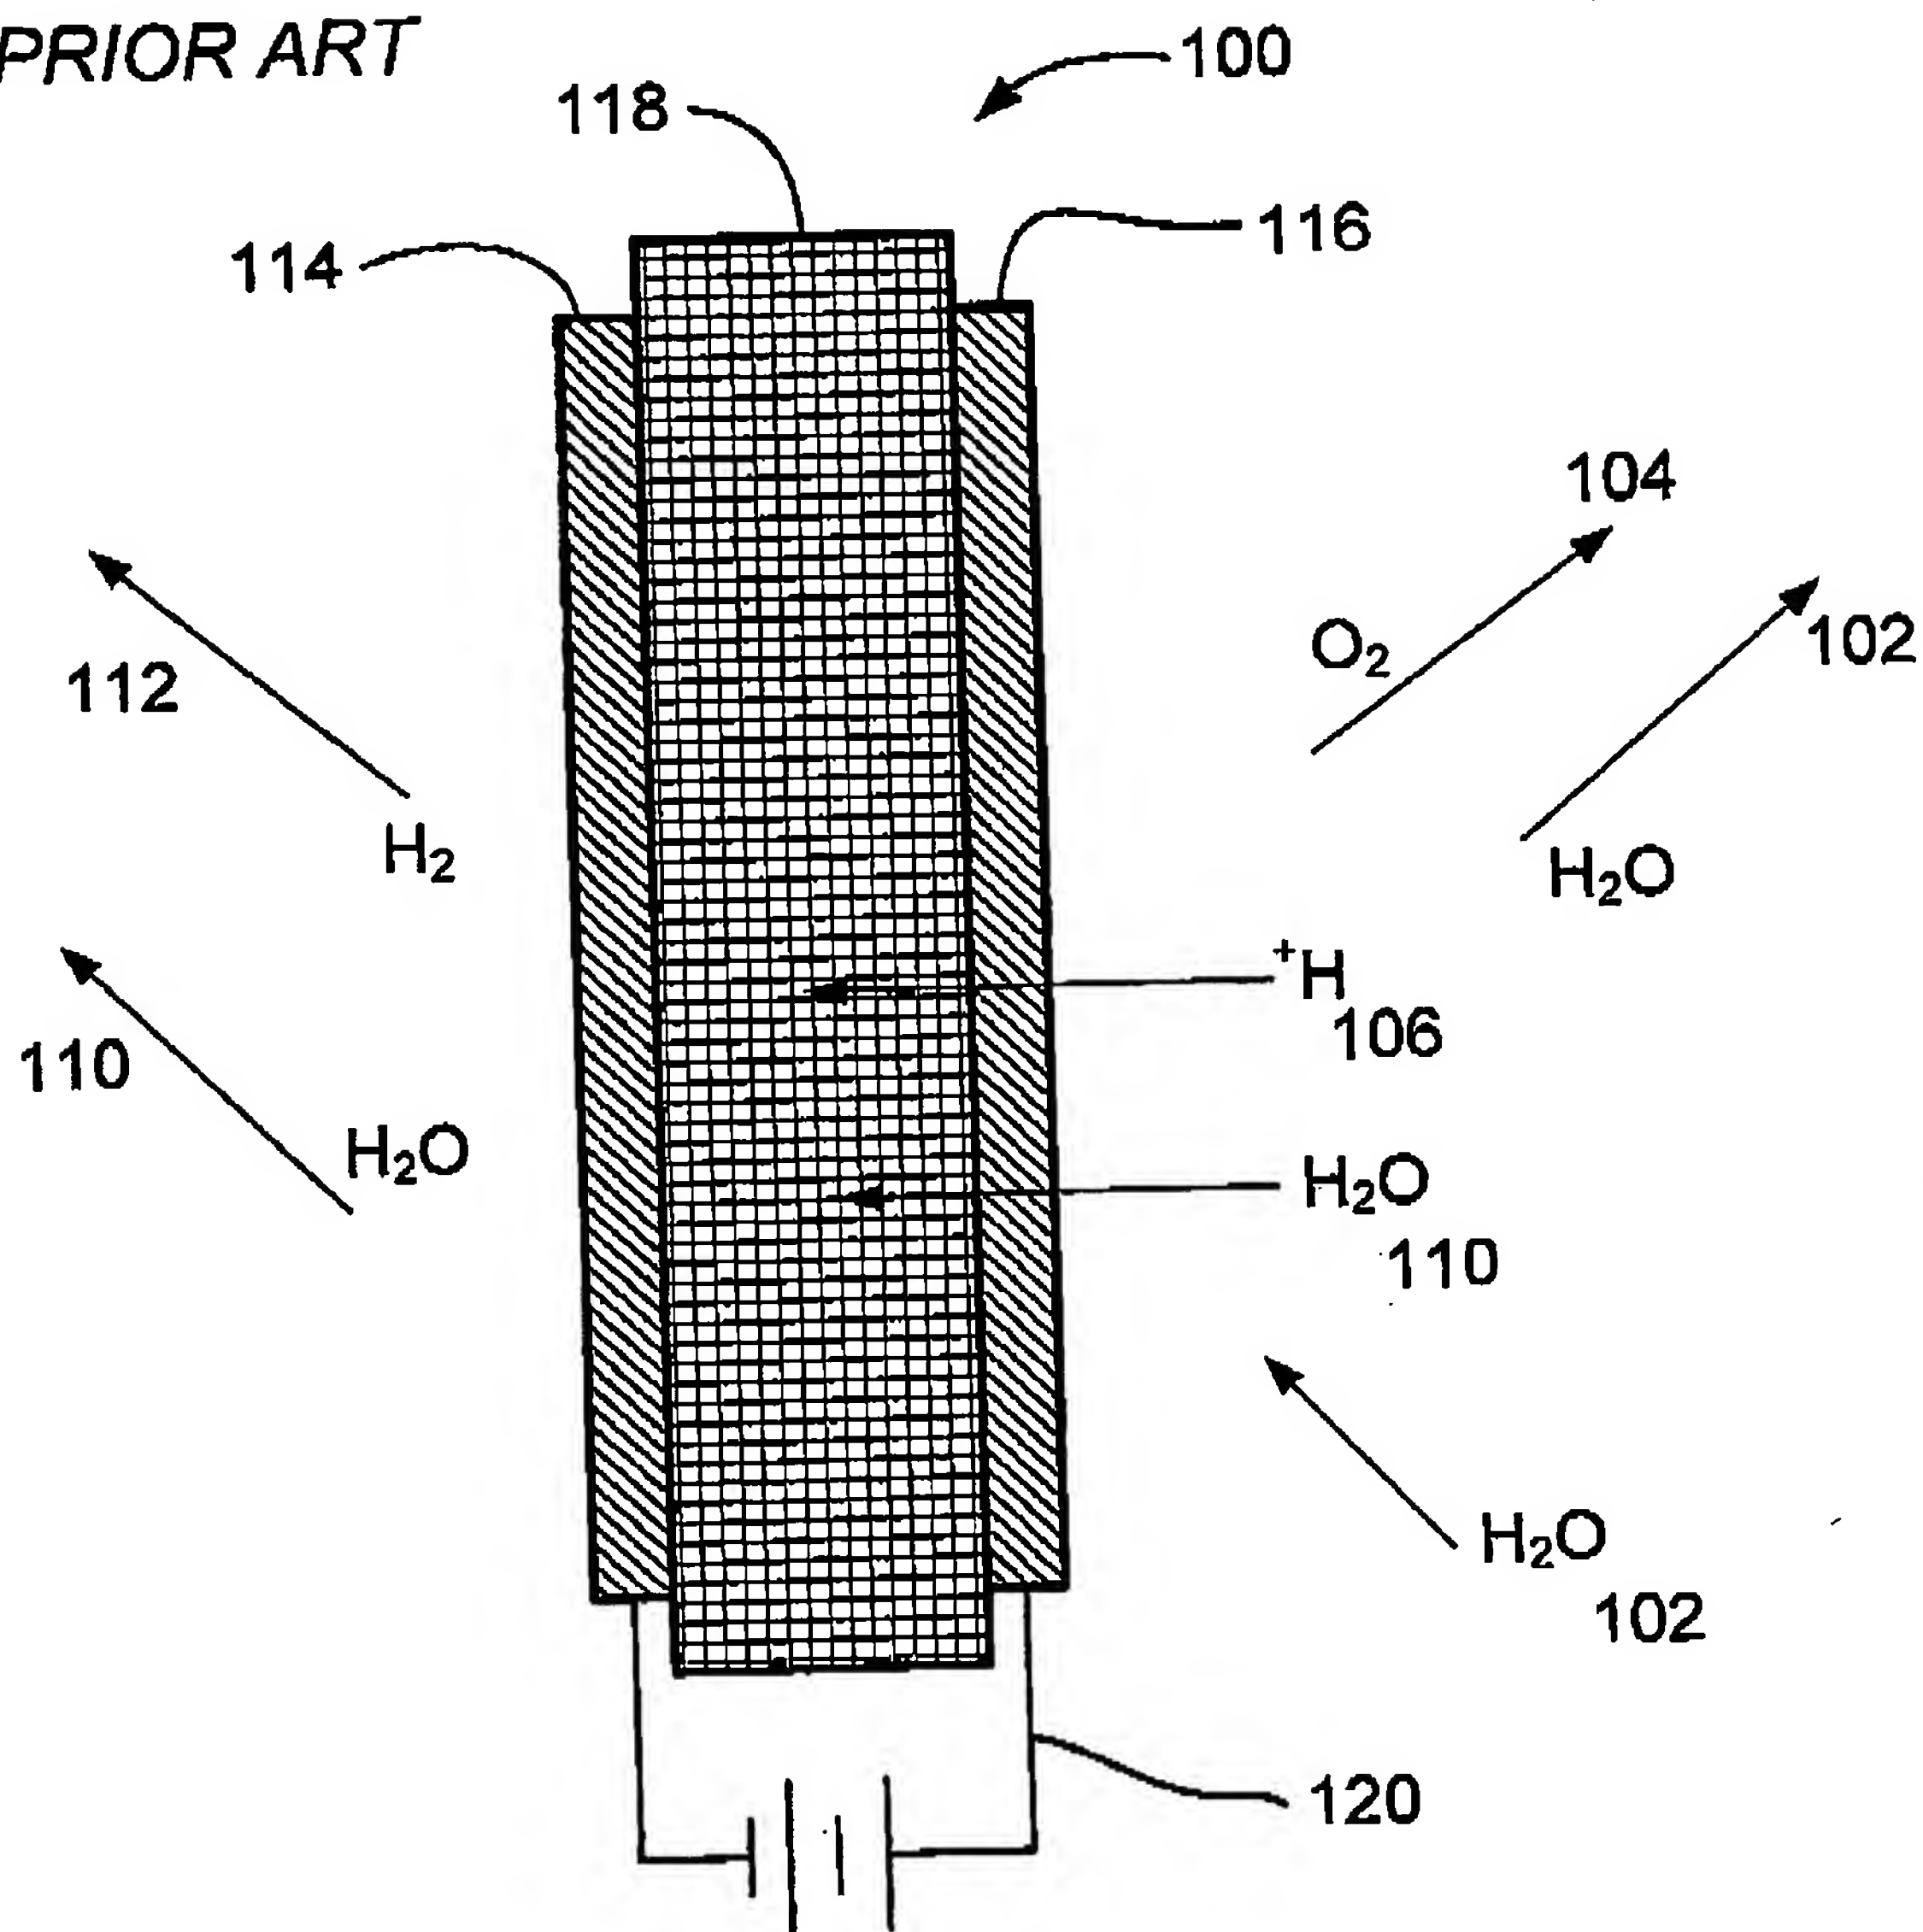